

STATE OF UTAH
DEPARTMENT OF NATURAL RESOURCES
DIVISION OF OIL, GAS AND MINING
1594 West North Temple - Suite 1210
Box 145801
Salt Lake City, Utah 84114-5801
Telephone: (801) 538-5291
Fax: (801) 359-3940

LARGE MINING OPERATIONS 2008 PROGRESS REPORT
January 1, 2008 to December 31, 2008

The information required in this form are based on provisions of the Mined Land Reclamation Act, Title 40-8, and the rules as under the Utah Minerals Regulatory Program.

1. Mine Permit Number: M030037
2. Mine Name: North Shore Natural Processing
3. Name of Operator/Permittee: North Shore Limited Partnership

Note: If Operator's address, company representative or phone number have changed, please provide a replacement page for the Notice of Intention.

4. Mine Location: Section 9 township 11 N. Range 9 W.
5. Report the gross amount of ore mined and waste moved, and the disposition of the materials (onsite stockpiles, sold, waste pile, regraded, etc.):

Gross Ore Mined _____ Tons, or _____ yd³ ± 125 acre feet GSL Brine
Waste Material Moved _____ Tons, or _____ yd³
New Disturbance 0.22 Acres during 2008
Area Reclaimed 0 Acres during 2008
Total Disturbed Area 25.5 Acres*

*Total mine disturbance from the beginning of mining operations through the end of 2008.

Was the ore shipped off site? If not, where is the ore located? Concentrated
brine is stored on site until sold to MRI
Where is the waste located? Pond beds and alongside canal

6. Briefly describe the reclamation work performed during the past year. A map showing reclaimed areas and dates is suggested. (Submit form MR-SITE for an application for full or partial bond/site release).
Some salt and other minerals have
been returned to lake bed
7. Include an updated map depicting surface disturbance and reclamation performed during the year, prepared in accordance with Rule R647-4-105.

I hereby certify, under penalties of law, the information provided in this report is true and correct to the best of my knowledge and belief.


Name (Typed or Print): Corey Anderson
Title of Operator: General Partner
Signature of Operator: [Signature]
Date: May 5, 2010

RECEIVED

MAY 10 2010

DIV. OF OIL, GAS & MINING

2008 Disturbed Acres with future plans

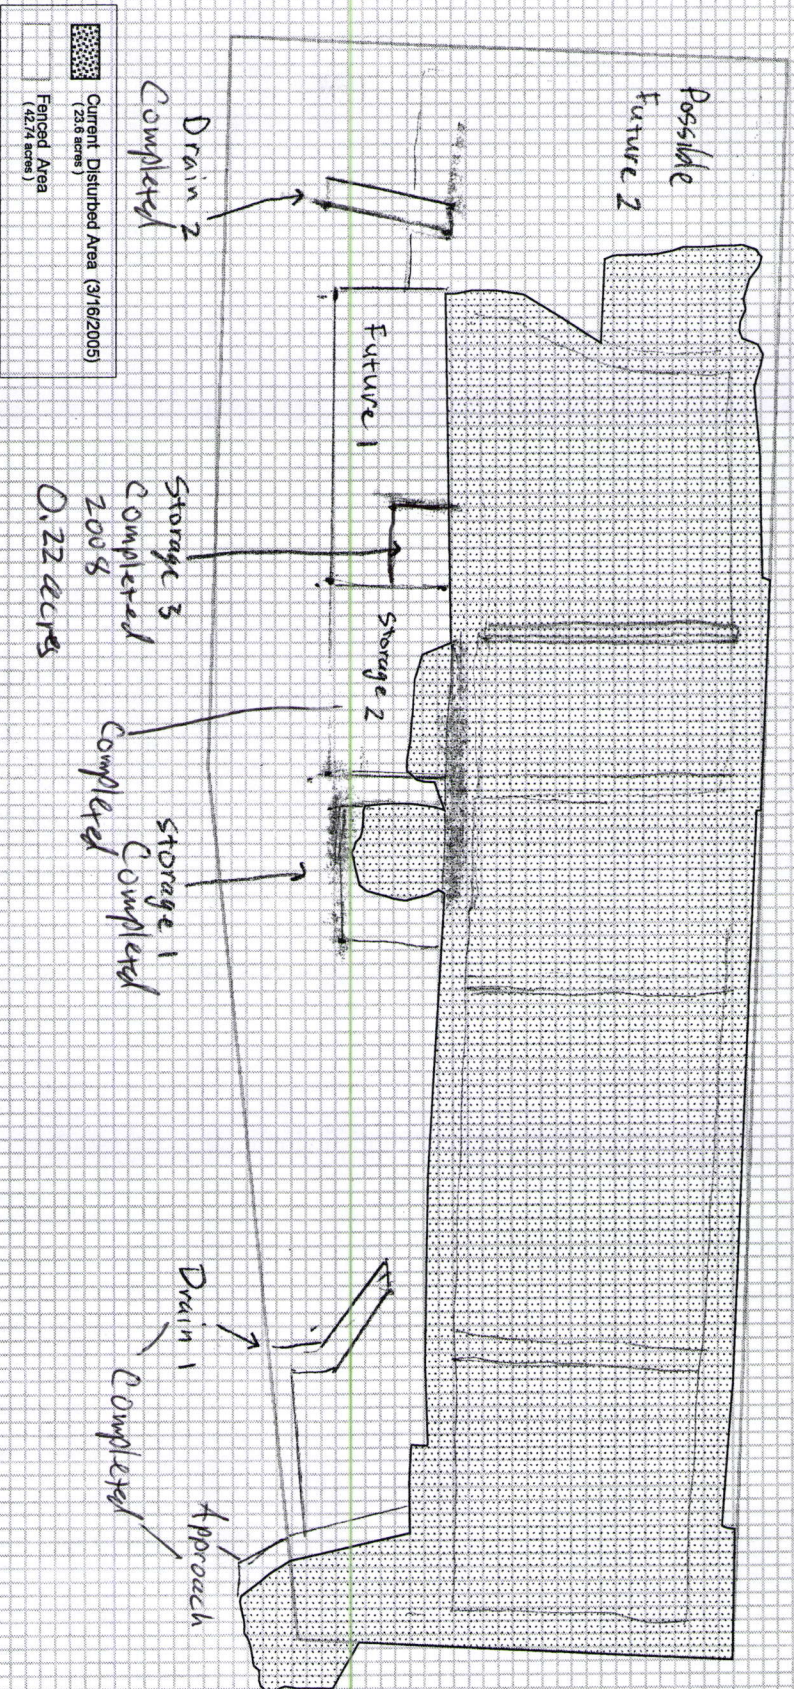

Total Disturbed Area 12/31/08
25.5 Acres

Dept. of Natural Resources
Division of Oil, Gas & Mining
Natural Gas Program
This product may not meet every
requirement for accuracy and content.



Portions of
Section 10 of the Northwest 1/4 of Sec. 10
Township 11 South, Range 9 West, S. 10W
Box Elder County, Utah

Northshore Limited Partnership
Northshore Natural Processing
M0003037

March 17, 2005

Drawn by LX